

LABOR AND MATERIALS


1	Copper	} Connection <u>3/4"</u>	\$
Lead			
1	Curb	} <u>3/4" orrisal</u> Valve T.S. & V.	\$
1	Service box	} { Short <u>3 1/2 x 4 1/2</u> Long <u>4 1/2 x 5 1/2</u> Buff or Rdway	\$
Old returned			
32	Ft. <u>3/4</u> in.	} { Copper G.I. C.I.	Pipe at \$
	Nipples	in. at	\$
	Bushings	to in. at	\$
	Red'g		
	Inc'g	Coupl'gs. to in. at	\$
	Union	in. at	\$
	Meter	in. at	\$
	Lead Joints	at	\$
	Compound Joints	at	\$
	Maintenance Foreman		\$
	Hrs. Water Maint. Man-1	at	\$
	Hrs. Water Maint. Man-2	at	\$
	Hrs. Garage Foreman	at	\$
	Hrs. Labor	at	\$
	Hrs. Compressor	at	\$
	Compensation Ins.	at \$ per C	\$
	Trucking		\$
	Pav't Patch		\$
	Tap by Gifford & Co.		\$
			\$
			\$
	O'head		\$
			\$

1-21-66.

Dr. Thornberry 21  
St. Ave. No. 78

Name of Owner Paul Roesch

Labor and Mat'l. Report Jan. 21 1966.

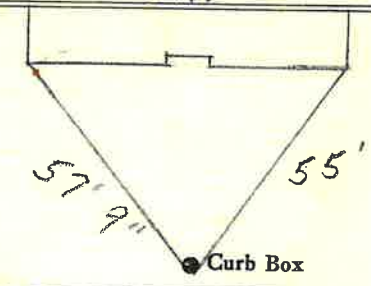

8" Main Elev. of Main at tap 4'

Gate at • Gate at  
3/4" Copper 32' to main

• Curb Box

TAX ID # 309.19.4-5