

LABOR AND MATERIALS

1 Copper } Connection $\frac{3}{4}$ in. \$
 Lead }
 1 Curb } Cock } $\frac{3}{4}$ in. Oriseat. \$
 Valve }
 T.S. & V. }
 1 Service box { Short $3\frac{1}{2}$ x $4\frac{1}{2}$ } \$
 Old returned { Long $4\frac{1}{2}$ x $5\frac{1}{2}$ }
 { Buff or Rdway }
 10 Ft. $\frac{3}{4}$ in. { Copper } Pipe at \$
 { G.I. }
 { C.I. }
 Nipples in. at \$
 Bushings to in. at \$
 Red'g }
 Inc'g } Coupl'gs to in. at \$
 Union in. at \$
 Meter in. at \$
 Lead Joints at \$
 Compound Joints at \$
 Maintenance Foreman \$
 Hrs. Water Maint. Man-1 at \$
 Hrs. Water Maint. Man-2 at \$
 Hrs. Garage Foreman at \$
 Hrs. Labor at \$
 Hrs. Compressor at \$
 Compensation Ins. at \$ per C \$
 Trucking \$
 Pav't Patch \$
 Tap by Seymour & Co. \$
 12-2-70 \$
 O'head \$
 \$

Jr.
 St.
 Pl.
 Ave. No. 22


Thornberry

Name of Owner

John C. Hughes.

Labor and Mat'l. Report

Dec. 2 1970

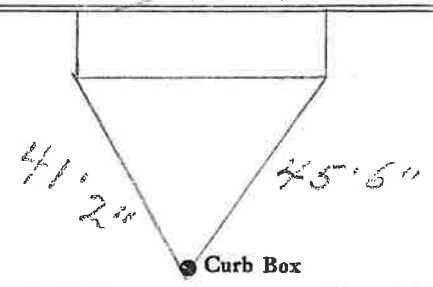

8" Main

Elev. of Main at tap 4'

Gate at •

• Gate at

$\frac{3}{4}$ " copper

10' to main

• Curb Box

TAX ID# 309.15-8-61