

LABOR AND MATERIALS

Copper	} Connection	_____	\$ _____		
Lead					
Curb	} Cock Valve T. S. & V.	} _____ in.	\$ _____		
				} Short 3 1/2 x 4 1/2	\$ _____
Service box Old returned					
Ft. 3/4 in.	} Copper C.I. C.I.	} Pipe at _____	\$ _____		
Nipples _____ in. at _____				\$ _____	
Bushings _____ to _____ in. at _____			\$ _____		
Red'g } Inc'g }	} Coupl'gs. _____ to _____ in. at _____		\$ _____		
Union _____ in. at _____				\$ _____	
Meter _____ in. at _____			\$ _____		
_____			\$ _____		
Compound Joints at _____			\$ _____		
Maintenance Foreman _____			\$ _____		
Hrs. Water Maint. Man-1 at _____			\$ _____		
Hrs. Water Maint. Man-2 at _____			\$ _____		
Hrs. Garage Foreman _____ at _____			\$ _____		
Hrs. Labor _____ at _____			\$ _____		
Hrs. Compressor at _____			\$ _____		
_____			\$ _____		
Trucking _____			\$ _____		
Pav't Patch _____			\$ _____		
_____			\$ _____		
_____			\$ _____		
_____			\$ _____		
_____			\$ _____		

THORNBERRY


DA.
St.
Pt.
Ave. No. 23

Name of Owner

Tax ID # 309.19-4-4

Labor and Mat'l. Report

19 88

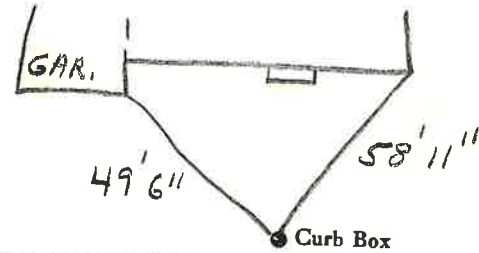

Main _____ Elev. of Main at tap _____
 Gate at ● _____ Gate at ● _____
 ● Curb Box