


LABOR AND MATERIALS

1	Copper Lead	Connection	$\frac{3}{4}$ "	\$
1	Curb	Cock Valve T.S. & V.	$\frac{3}{4}$ in. <i>Oriseal</i>	\$
1	Service box	{ Short $3\frac{1}{2}$ x $4\frac{1}{2}$ Long $4\frac{1}{2}$ x $5\frac{1}{2}$ Buff or Rdway }		\$
	Old returned			
7	Ft. $\frac{3}{4}$ in.	Copper C.I. C.I.	Pipe at	\$
	Nipples	in. at		\$
	Bushings	to in. at		\$
	Red'g Inc'g	Coupl'gs to in. at		\$
	Union	in. at		\$
	Meter	in. at		\$
	Lead Joints	at		\$
	Compound Joints	at		\$
	Maintenance Foreman			\$
	Hrs. Water Maint. Man-1	at		\$
	Hrs. Water Maint. Man-2	at		\$
	Hrs. Garage Foreman	at		\$
	Hrs. Labor	at		\$
	Hrs. Compressor	at		\$
	Compensation Ins. at \$	per C		\$
	Trucking			\$
	Pav't Patch			\$
	<i>Tap by Gifford & Co.</i>			\$
	<i>1-19-66</i>			\$
	O'head			\$

Thornberry Dr. ~~St.~~ ~~St.~~ Ave. No. *24*

Name of Owner *Robert Brayman*

Labor and Mat'l. Report *Jan. 19* 19*66*

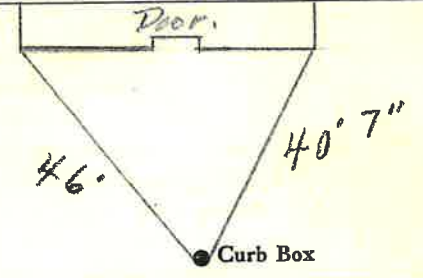

8' Main Elev. of Main at tap *4'*

Gate at • Gate at •

$\frac{3}{4}$ " Copper *7' to MAIN*

• Curb Box

TAX ID # *309.15-8-62*