

LABOR AND MATERIALS


1 Copper } Connection 3/4" \$
 Lead }
 1 Curb } Cock } 3/4 in. MARK II \$
 Valve } GRISEL
 T.S. & V. }
 1 Service box { Short 3 1/2 x 4 1/2 } \$
 Old returned { Long 4 1/2 x 5 1/2 }
 Bufl or Rdway }
 34 Ft. 3/4 in. { Copper } Pipe at \$
~~Curb~~
 Nipples in. at \$
 Bushings to in. at \$
 1 Red'g } Coupl'gs. 1" to 3/4" at \$
 Lead'g }
 Union in. at \$
 Meter in. at \$
 1 Lead Joints at 3/4" MALE ADAPTER \$
 Compound Joints at \$
 Maintenance Foreman \$
 Hrs. Water Maint. Man-1 at \$
 Hrs. Water Maint. Man-2 at \$
 Hrs. Garage Foreman at \$
 Hrs. Labor at \$
 Hrs. Compressor at \$
 Compensation Ins. at \$ per C \$
 Trucking \$
 Pav't Patch \$
 Tap Made By Peck & Co \$
 O'head MAY-1-1972 \$

NOTE -
 This Tap on Side of MAIN

St. Thornberry Drive
 Pl: Ave. No. 25

Name of Owner
John C. Hughes

Labor and Mat'l. Report MAY-1 1972

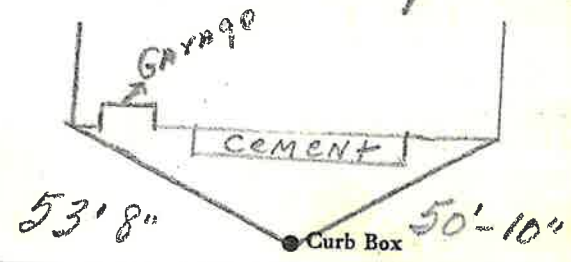

8" Main Elev. of Main at tap 3'
 Gate at • Gate at

3/4" copper 34' to main
 • Curb Box

TAX ID # 309.19-4-3