


LABOR AND MATERIALS

1	Copper	Connection	3/4"	\$
1	Curb	Cock Valve T.S. & V.	3/4" in. MARK II ORISEAL	\$
1	Service box Old returned	Short 3 1/2 x 4 1/2 Long 4 1/2 x 5 1/2 Buff. or Rdway		\$
29	Ft. 3/4 in.	Copper Pipe at		\$
	Nipples	in. at		\$
	Bushings	to in. at		\$
	Red'g Inc'g	Coupl'gs to in. at		\$
	Union	in. at		\$
	Meter	in. at		\$
	Lead Joints at			\$
	Compound Joints at			\$
	Maintenance Foreman			\$
	Hrs. Water Maint. Man-1 at			\$
	Hrs. Water Maint. Man-2 at			\$
	Hrs. Garage Foreman at			\$
	Hrs. Labor at			\$
	Hrs. Compressor at			\$
	Compensation Ins. at \$	per C		\$
	Trucking			\$
	Pav't Patch			\$
	TAP MADE BY HAREAN			\$
	O'head	JUNE 1-1972		\$

THORN BERRY DRIVE Ave. No. 7

Name of Owner
MARIE WHITE

Labor and Mat'l. Report JUNE 1 1972

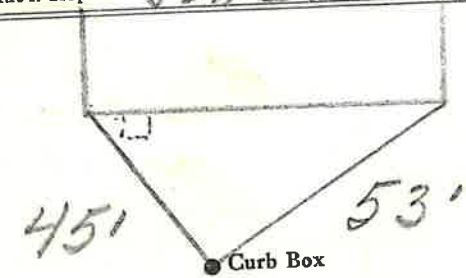

8" Main Elev. of Main at tap 6'

Gate at • Gate at •
3/4" Copper 29' to main
• Curb Box