


LABOR AND MATERIALS

1	Copper Lead	Connection	3/4"	\$
1	Curb	Cock Valve T.S. & V.	3/4 in. Oriseal	\$
1	Service box	Short 3 1/2 x 4 1/2		
	Old returned	Long 4 1/2 x 5 1/2		
		Buff or Rdway		\$
8	Ft. 3/4 in.	Copper Pipe at		\$
		C.I.		
		C.I.		
	Nipples	in. at		\$
	Bushings	to in. at		\$
	Red'g			
	Inc'g	Coupl'gs. to in. at		\$
	Union	in. at		\$
	Meter	in. at		\$
	Lead Joints	at		\$
	Compound Joints	at		\$
	Maintenance Foreman			\$
	Hrs. Water Maint. Man-1	at		\$
	Hrs. Water Maint. Man-2	at		\$
	Hrs. Garage Foreman	at		\$
	Hrs. Labor	at		\$
	Hrs. Compressor	at		\$
	Compensation Ins. at \$	per C		\$
	Trucking			\$
	Pav't Patch			\$
	Tap by Gifford & Co.			\$
	1-21-66.			\$
	O'head			\$

Dr. Thornberry Ave. No. 26
~~Str~~
~~Pl~~

Name of Owner James Kelly.

Labor and Mat'l. Report Jan 21 1966

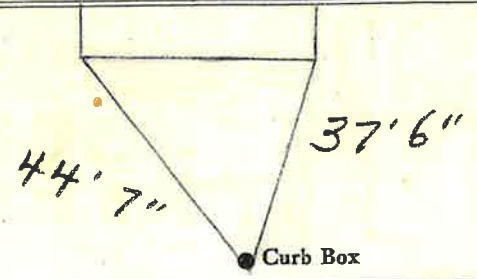

8' Main Elev. of Main at tap 3' +

Gate at • Gate at •
 3/4" copper 8' to main

• Curb Box
 TAX ID # 309.19-5-1