

## LABOR AND MATERIALS

Copper	Connection			\$						
Lead										
Curb	Cock Valve T.S. & V.	} in.			\$					
Service box	} Short 3½ x 4½ Long 4½ x 5½ Buff or Rdway				\$					
Old returned										
Pt. ¾ in.	} Copper G.I. G.I.	} Pipe at			\$					
Nipples	in. at				\$					
Bushings	to in. at				\$					
Red'g Inc'g	} Coupl'gs	to in. at			\$					
Union	in. at				\$					
Meter	in. at				\$					
Lead Joints at					\$					
Compound Joints at					\$					
Maintenance Foreman					\$					
Hrs. Water Maint. Man-1	at				\$					
Hrs. Water Maint. Man-2	at				\$					
Hrs. Garage Foreman	at				\$					
Hrs. Labor	at				\$					
Hrs. Compressor at					\$					
Compensation Ins. at \$	per C				\$					
Trucking					\$					
Pav't Patch					\$					
					\$					
					\$					
					\$					
O'head					\$					
					\$					

Dr.  
St.  
Pl.  
Ave. No. 27

Thomberg

---


Name of Owner

TAX ID # 309.19-4-2

---

Labor and Mat'l. Report 19 86

---

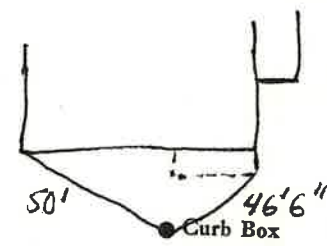

Main Elev. of Main at tap

Gate at ● ● Gate at

---

● Curb Box