

LABOR AND MATERIALS

Copper	} Connection			\$	
Lead					
Curb	} Cock Valve	in.		\$	
	} T. S. & V.				
Service box	}	Short 3½ x 4½		\$	
Old returned		Long 4½ x 5½			
		Buff or Rdway			
Ft. ¾ in.	}	Copper	Pipe at	\$	
		G.I.			
		C.I.			
Nipples	in. at			\$	
Bushings	to in. at			\$	
Red'g	}	Coupl'gs	to in. at	\$	
Inc'g					
Union	in. at			\$	
Meter	in. at			\$	
Lead Joints at				\$	
Compound Joints at				\$	
Maintenance Foreman				\$	
Hrs. Water Maint. Man—1 at				\$	
Hrs. Water Maint. Man—2 at				\$	
Hrs. Garage Foreman at				\$	
Hrs. Labor— at				\$	
Hrs. Compressor at				\$	
Compensation Ins. at \$		per C		\$	
Trucking				\$	
Pav't Patch				\$	
				\$	
				\$	
O'head				\$	


Du.
St.
Pt.
Ave. No. 29

Rhomberry

Name of Owner _____

TAX ID# 309.19-4-1

Labor and Mat'l. Report 19 86

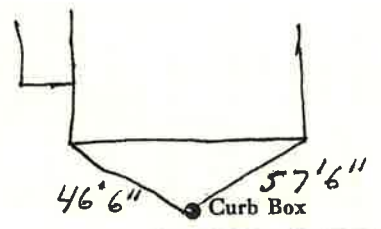

Main Elev. of

Main at tap

Gate at ● ● Gate at

● Curb Box