

LABOR AND MATERIALS

Copper	}	Connection			\$
Lead					
Curb	}	Cock	} in.		\$
		Valve			
		T. S. & V.			
Service box	}	Short 3½ x 4½	} _____		\$
Old returned		Long 4½ x 5½			
		Buff or Rdway			
Ft. ¾ in.	}	Copper	} Pipe at _____		\$
		G.I.			
		G.I.			
Nipples		in. at _____			\$
Bushings		to _____ in. at _____			\$
Red'g	}	Coupl'gs	to _____ in. at _____		\$
Inc'g					
Union		in. at _____			\$
Meter		in. at _____			\$
Lead Joints		at _____			\$
Compound Joints		at _____			\$
Maintenance Foreman		_____			\$
Hrs. Water Maint. Man-1		at _____			\$
Hrs. Water Maint. Man-2		at _____			\$
Hrs. Garage Foreman		at _____			\$
Hrs. Labor		at _____			\$
Hrs. Compressor		at _____			\$
Compensation Ins. at \$		_____ per C			\$
Trucking		_____			\$
Pav't Patch		_____			\$
		_____			\$
		_____			\$
		_____			\$
O'head		_____			\$
		_____			\$


Dr.
St.
Pl.
Ave. No. 30

Thornberry

Name of Owner _____

TAX ID # 309.19-5-3

Labor and Mat'l. Report _____ 19 86

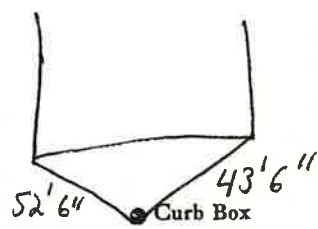

Main Elev. of
Main at tap _____

Gate at ● ● Gate at _____

● Curb Box