

LABOR AND MATERIALS

<u>1/4</u> Copper } Connection _____ \$ _____	
Lead } _____ \$ _____	
<u>1</u> Curb } Cock } <u>3/4</u> in. _____ \$ _____	
	Valve } _____ \$ _____
	T. S. & V. } _____ \$ _____
<u>1</u> Service box } Short <u>3 1/2</u> x <u>4 1/2</u> _____ \$ _____	
Old returned } Long <u>4 1/2</u> x <u>5 1/2</u> _____ \$ _____	
	Buff or Rdway } _____ \$ _____
<u>31</u> Ft. <u>3/4</u> in. } Copper } Pipe at _____ \$ _____	
	G.I. } _____ \$ _____
	C.I. } _____ \$ _____
Nipples _____ in. at _____ \$ _____	
Bushings _____ to _____ in. at _____ \$ _____	
Red'g } _____ \$ _____	
Inc'g } Coupl'gs _____ to _____ in. at _____ \$ _____	
Union _____ in. at _____ \$ _____	
Meter _____ in. at _____ \$ _____	
Lead Joints at _____ \$ _____	
Compound Joints at _____ \$ _____	
Maintenance Foreman _____ \$ _____	
Hrs. Water Maint. Man—1 at _____ \$ _____	
Hrs. Water Maint. Man—2 at _____ \$ _____	
Hrs. Garage Foreman _____ at _____ \$ _____	
Hrs. Labor— _____ at _____ \$ _____	
Hrs. Compressor at _____ \$ _____	
Compensation Ins. at \$ _____ per C _____ \$ _____	
Trucking _____ \$ _____	
Pav't Patch _____ \$ _____	
<u>Tap by Peck & Co</u> _____ \$ _____	
<u>7-20-71</u> _____ \$ _____	
O'head _____ \$ _____	
_____ \$ _____	

Thornberry


St. 33
Pl. 33
Ave. No. 33

Name of Owner

Ross Wilson

Labor and Mat'l. Report

7-6- 1971

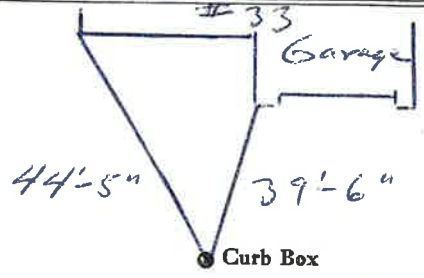

8" Main

Elev. of Main at tap 11'

Gate at •

• Gate at

3/4" copper

31' to main

• Curb Box

TAX ID # 309.19-6-7