

LABOR AND MATERIALS

Copper	} Connection		\$	
Lead				
Curb	} Cock } Valve } T. S. & V.	in.	\$	
Service box		} Short 3 1/2 x 4 1/2 } Long 4 1/2 x 5 1/2		
Old returned				\$
17 Ft.	} Copper } G.I. } C.T.	Pipe at	\$	
in.				
Nipples	in. at		\$	
Bushings	to in. at		\$	
Red'g Inc'g	} Coupl'gs	to in. at	\$	
Union		in. at	\$	
Meter	in. at		\$	
			\$	
Compound Joints	at		\$	
Maintenance Foreman			\$	
Hrs. Water Maint. Man-1	at		\$	
Hrs. Water Maint. Man-2	at		\$	
Hrs. Garage Foreman	at		\$	
Hrs. Labor	at		\$	
Hrs. Compressor	at		\$	
			\$	
Trucking			\$	
Pav't Patch			\$	
			\$	
			\$	
			\$	
			\$	


Dr. _____
St. _____
Pt. _____
Ave. No. _____

Rhombery

Name of Owner _____

TAX ID # 309.19-5-4

Labor and Mat'l. Report 1990

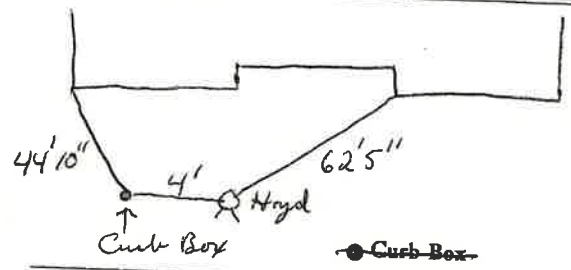

8" Main Elev. of
Main at tap _____

Gate at • • Gate at

3/4" copper 17' to main

• Curb Box