


LABOR AND MATERIALS

| | | | | | |
|----|-------------------------|--|---------|--------|-------|
| 1 | Copper | Connection | 3/4" | \$ | _____ |
| 1 | Curb | | | | |
| 1 | Curb | Cock Valve | 3/4" | \$ | _____ |
| 1 | Service box | | | | |
| | Old returned | { Short 3 1/2 x 4 1/2 } { Long 4 1/2 x 5 1/2 } { Buff or Rdway } | | \$ | _____ |
| 31 | Ft. | Copper | 3/4 in. | \$ | _____ |
| | | | | | |
| | Nipples | in. at | | \$ | _____ |
| | Bushings | to | in. at | \$ | _____ |
| | Red'g | Coupl'gs | to | in. at | \$ |
| | Inc'g | | | | |
| | Union | in. at | | \$ | _____ |
| | Meter | in. at | | \$ | _____ |
| | Lead Joints | at | | \$ | _____ |
| | Compound Joints | at | | \$ | _____ |
| | Maintenance Foreman | | | \$ | _____ |
| | Hrs. Water Maint. Man-1 | at | | \$ | _____ |
| | Hrs. Water Maint. Man-2 | at | | \$ | _____ |
| | Hrs. Garage Foreman | at | | \$ | _____ |
| | Hrs. Labor | at | | \$ | _____ |
| | Hrs. Compressor | at | | \$ | _____ |
| | Compensation Ins. | at \$ | per C | \$ | _____ |
| | Trucking | | | \$ | _____ |
| | Pav't Patch | | | \$ | _____ |
| | | | | \$ | _____ |
| | Tap made By | Beecher | | \$ | _____ |
| | O'head | July 27, 77 | | \$ | _____ |
| | | | | \$ | _____ |

St
 Thorn Berry Dr Pt. Ave. No. 35

Name of Owner
 John C. Hughes

Labor and Mat'l. Report July 27 - 1977

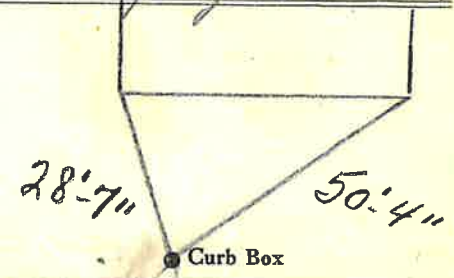

8" Main Elev. of Main at tap 7'
 Gate at ● Gate at ●

● Curb Box

TAX ID# 309.19-6-6