


LABOR AND MATERIALS

1	Copper	} Connection <u>3/4"</u>	\$
1	Lead		
1	Curb	} Cock Valve T. S. & V. } <u>3/4 in. ORIS 1</u>	\$
1	Service box		
	Old returned	} Short <u>3 1/2 x 4 1/2</u> Long <u>4 1/2 x 5 1/2</u> Buff. or Rdway }	\$
17	Ft. <u>3/4</u> in.		} Copper C.I. } Pipe at
	Nipples	in. at	
	Bushings	to in. at	\$
	Red'g	} Coupl'gs	to in. at \$
	Inc'g		
	Union	in. at	\$
	Meter	in. at	\$
	Lead Joints	at	\$
	Compound Joints	at	\$
	Maintenance Foreman		\$
	Hrs. Water Maint. Man-1	at	\$
	Hrs. Water Maint. Man-2	at	\$
	Hrs. Garage Foreman	at	\$
	Hrs. Labor	at	\$
	Hrs. Compressor	at	\$
	Compensation Ins. at \$	per C	\$
	Trucking		\$
	Pav't Patch		\$
	<u>Tap made by Parvis & Co</u>		
	<u>June-10-1975</u>		
	O'head		\$

St. PF. No. 36
Thornberry DR

Name of Owner
John Donovan

Labor and Mat'l. Report JUNE 10 1975

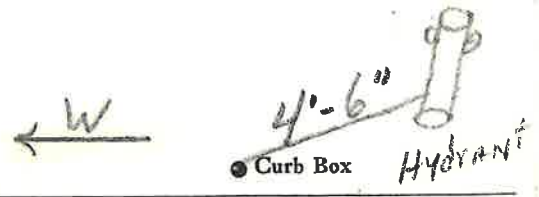

8" Main Elev. of Main at tap 7'

Gate at • Gate at
3/4" Copper 17' to main

• Curb Box
 TAX # 309.19-5-5