


LABOR AND MATERIALS

Copper } Connection _____ \$ _____	
Lead } _____ \$ _____	
Curb } Cock Valve } _____ in. \$ _____	
	T. S. & V. }
Service box } Short 3½ x 4½ } _____ \$ _____	
Old returned } Long 4½ x 5½ } _____ \$ _____	
28 Ft. ¾ in. } Copper } Pipe at _____ \$ _____	
	G.I. }
	C.I. }
Nipples _____ in. at _____ \$ _____	
Bushings _____ to _____ in. at _____ \$ _____	
Red'g } Coupl'gs _____ to _____ in. at _____ \$ _____	
Inc'g }	
Union _____ in. at _____ \$ _____	
Meter _____ in. at _____ \$ _____	
_____ \$ _____	
Compound Joints at _____ \$ _____	
Maintenance Foreman _____ \$ _____	
Hrs. Water Maint. Man—1 at _____ \$ _____	
Hrs. Water Maint. Man—2 at _____ \$ _____	
Hrs. Garage Foreman _____ at _____ \$ _____	
Hrs. Labor— _____ at _____ \$ _____	
Hrs. Compressor at _____ \$ _____	
_____ \$ _____	
Trucking _____ \$ _____	
Pav't Patch _____ \$ _____	
_____ \$ _____	
_____ \$ _____	
Dr. _____
 St. _____
 Pt. _____
 Ave. No. 37

Name of Owner
Rhomberry
 TAX ID# 309.19-6-5

Labor and Mat'l. Report 19 90

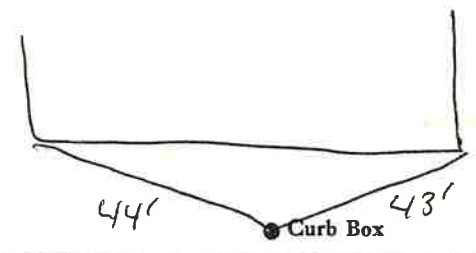

8" Main Elev. of Main at tap _____
 Gate at • Gate at •

¾" Copper 28' to main
 • Curb Box

Depth - 5½'