

LABOR AND MATERIALS

Copper	} Connection	_____	\$ _____	
Lead				
Curb	} Cock } Valve } T. S. & V. }	_____ in.	\$ _____	
Service box		} Short 3½ x 4½ } } Long 4½ x 5½ }		
Old returned				\$ _____
Ft. <u>3/4</u> in.	} Copper } G.I. } C.I. }	Pipe at _____	\$ _____	
Nipples		_____ in. at _____	\$ _____	
Bushings		_____ to _____ in. at _____	\$ _____	
Red'g	} Coupl'gs	_____ to _____ in. at _____	\$ _____	
Inc'g				
Union	_____ in. at _____	\$ _____		
Meter	_____ in. at _____	\$ _____		
_____			\$ _____	
Compound Joints	at _____	\$ _____		
Maintenance Foreman	_____	\$ _____		
Hrs. Water Maint. Man—1	at _____	\$ _____		
Hrs. Water Maint. Man—2	at _____	\$ _____		
Hrs. Garage Foreman	at _____	\$ _____		
Hrs. Labor—	at _____	\$ _____		
Hrs. Compressor	at _____	\$ _____		
_____			\$ _____	
Trucking	_____	\$ _____		
Pav't Patch	_____	\$ _____		
_____			\$ _____	
_____			\$ _____	
_____			\$ _____	
_____			\$ _____	


DR.  
-Str-  
-Pl-  
Ave. No. 39

THORNBERY

Name of Owner \_\_\_\_\_

TAX ID # 309.19-6-4

Labor and Mat'l. Report 19 93

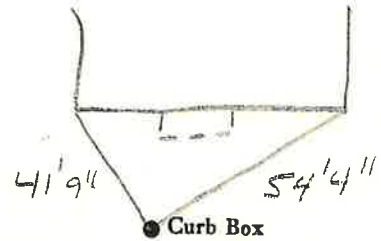

8" Main Elev. of  
Main at tap \_\_\_\_\_

Gate at ● ● Gate at

● Curb Box