

LABOR AND MATERIALS


1	Copper	Connection	3/4"	\$
1	Curb	Cock Valve	3/4 in. <i>ORISCAL</i>	\$
1	Service box	Short 3 1/2 x 4 1/2		\$
	Old returned	Long 4 1/2 x 5 1/2		\$
		Buff or Rdway		\$
16	Ft. 3/4 in.	Copper Pipe at		\$
	Nipples	in. at		\$
	Bushings	to in. at		\$
	Red'g Inc'g	Coupl'gs. to in. at		\$
	Union	in. at		\$
	Meter	in. at		\$
	Lead Joints	at		\$
	Compound Joints	at		\$
	Maintenance Foreman			\$
	Hrs. Water Maint. Man-1	at		\$
	Hrs. Water Maint. Man-2	at		\$
	Hrs. Garage Foreman	at		\$
	Hrs. Labor	at		\$
	Hrs. Compressor	at		\$
	Compensation Ins.	at \$ per C		\$
	Trucking			\$
	Pav't Patch			\$
	<i>TAP MADE BY GIFFORD & CO</i>			\$
	O'head	<i>April-7-1975</i>		\$

#4

Thoraberry Drive St. No. *8*

Name of Owner
Peter Bapp

Labor and Mat'l. Report *April 7 1975*

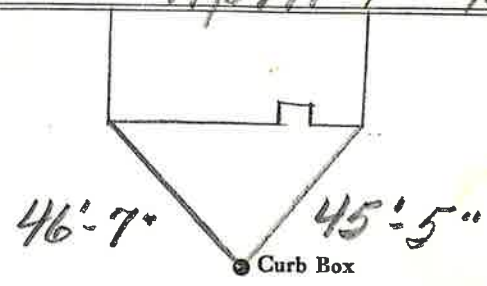

8" Main Elev. of Main at tap *5 1/2'*

Gate at • Gate at

3/4" Copper 16' to main

• Curb Box

✓