

LABOR AND MATERIALS


Copper	} Connection	_____	\$ _____	
Lead				
Curb	} Cock	_____ in.	\$ _____	
				} Valve
Service box	} Short 3½ x 4½	_____	\$ _____	
Old returned				Long 4½ x 5½
22 Ft.	} Copper	} Pipe at	\$ _____	
¾ in.				<del>C.I.</del>
Nipples	_____ in. at	\$ _____		
Bushings	_____ to _____ in. at	\$ _____		
Red'g	} Coupl'gs	_____ to _____ in. at	\$ _____	
Inc'g				
Union	_____ in. at	\$ _____		
Meter	_____ in. at	\$ _____		
Compound Joints	_____ at	\$ _____		
Maintenance Foreman	_____ at	\$ _____		
Hrs. Water Maint. Man	—1 at	\$ _____		
Hrs. Water Maint. Man	—2 at	\$ _____		
Hrs. Garage Foreman	_____ at	\$ _____		
Hrs. Labor	_____ at	\$ _____		
Hrs. Compressor	_____ at	\$ _____		
Trucking	_____	\$ _____		
Pav't Patch	_____	\$ _____		
		\$ _____		
		\$ _____		
		\$ _____		
		\$ _____		

DR.  
St.  
Pt.  
Ave. No. 41

THORN BERRY

Name of Owner  
TAX ID # 309.19-6-3

Labor and Mat'l. Report 1990

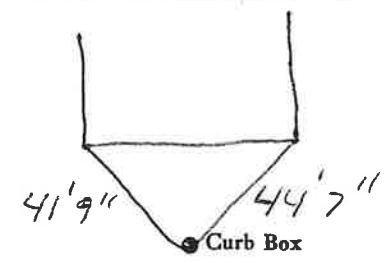

8" Main Elev. of Main at tap \_\_\_\_\_

Gate at • Gate at  
¾" copper 22' to MAIN

• Curb Box