


LABOR AND MATERIALS

_____	Copper } Connection _____	\$ _____
_____	Lead } _____	\$ _____
_____	Curb } Cock Valve } _____ in.	\$ _____
	TS & V. }	
_____	Service box { Short 3-1/2 x 4-1/2 }	\$ _____
	Old returned { Long 4-1/2 x 5-1/2 }	
9'10"	Ft. 3/4" in. { Copper } Pipe at _____	\$ _____
_____	Nipples _____ in. at _____	\$ _____
_____	Bushings _____ to _____ in. at _____	\$ _____
_____	Red'g _____	\$ _____
_____	Inc'g _____	\$ _____
_____	Union _____ in. at _____	\$ _____
_____	Meter _____ in. at _____	\$ _____
_____	Compound Joints at _____	\$ _____
_____	Maintenance Foreman _____	\$ _____
_____	Hrs. Water Maint. Man - 1 at _____	\$ _____
_____	Hrs. Water Maint. Man - 2 at _____	\$ _____
_____	Hrs. Garage Foreman _____ at _____	\$ _____
_____	Hrs. Labor _____ at _____	\$ _____
_____	Hrs. Compressor at _____	\$ _____
_____	_____	\$ _____
_____	Trucking _____	\$ _____
_____	Pav't Patch _____	\$ _____
_____	_____	\$ _____
_____	_____	\$ _____
St. 10
 Ave. No. 10
 Name of Owner THORNBERY
RICK WHITAMORE

Labor and Mat'l. Report 19 _____

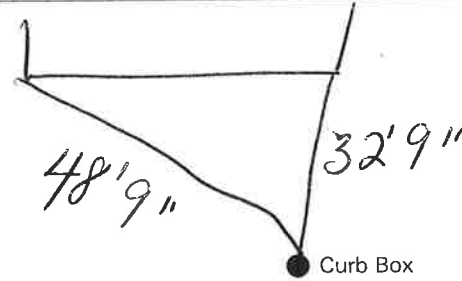

8" Main

Elev. of Main at tap 5'

Gate at ●

● Gate at

SEWER LATERAL GOES

IN TO MANHOLE ● Curb Box

TAX ID # 309.15-8-55