


LABOR AND MATERIALS

1	Copper Lead	Connection	3/4"	\$
1	Curb	Cock Valve T. S. & V.	3/4" Oriscat.	\$
1	Service box	{ Short 3 1/2 x 4 1/2 Long 4 1/2 x 5 1/2 Buff or Rdway }		\$
	Old returned			
10	Ft. 3/4 in.	Copper Pipe at		\$
		G.I.		\$
		C.I.		\$
	Nipples	in. at		\$
	Bushings	to in. at		\$
	Red'g Inc'g	Coupl'gs to in. at		\$
	Union	in. at		\$
	Meter	in. at		\$
	Lead Joints	at		\$
	Compound Joints	at		\$
	Maintenance Foreman			\$
	Hrs. Water Maint. Man-1	at		\$
	Hrs. Water Maint. Man-2	at		\$
	Hrs. Garage Foreman	at		\$
	Hrs. Labor	at		\$
	Hrs. Compressor	at		\$
	Compensation Ins.	at \$ per C		\$
	Trucking			\$
	Pav't Patch			\$
	Tap by Seymour & Co.			\$
				\$
				\$
	O'head			\$
				\$

Dr. St. Pl. Ave. No. 14  
 Thornberry

Name of Owner  
 John C. Hughes.

Labor and Mat'l. Report Dec. 1 19 70

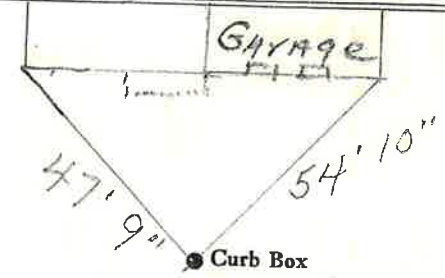

8" Main Elev. of Main at tap 4'

Gate at ● Gate at ●  
 3/4" Copper 10' to main  
 ● Curb Box

TAX ID# 309.15-8-57