


LABOR AND MATERIALS

1	Copper Lead	Connection	3/4"	\$
1	Curb	Cock Valve T.S. & V.	3/4" in. Oriseal.	\$
1	Service box	Short 3 1/2 x 4 1/2		
	Old returned	Long 4 1/2 x 5 1/2		\$
		Buff or Rdway		\$
34	Ft.	Copper G.I. G.I.	3/4" in. Pipe at	\$
	Nipples	in. at		\$
	Bushings	to in. at		\$
	Red'g Inc'g	Coupl'gs to in. at		\$
	Union	in. at		\$
	Meter	in. at		\$
	Lead Joints	at		\$
	Compound Joints	at		\$
	Maintenance Foreman			\$
	Hrs. Water Maint. Man-1	at		\$
	Hrs. Water Maint. Man-2	at		\$
	Hrs. Garage Foreman	at		\$
	Hrs. Labor	at		\$
	Hrs. Compressor	at		\$
	Compensation Ins.	at \$ per C		\$
	Trucking			\$
	Pav't Patch			\$
	Tap by Seymour & Co.			\$
	5-25-76			\$
	O'head			\$
				\$

Dr. St. Pl. Ave. No. 15  
 Thornberry

Name of Owner  
 Woodbury

Labor and Mat'l. Report May 25 1971

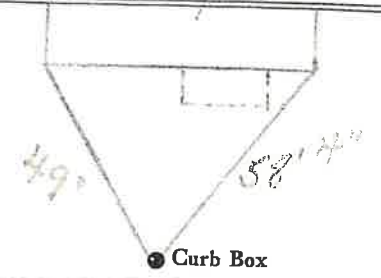

8" Main Elev. of Main at tap 4'

Gate at • Gate at

3/4" Copper 34' to main

• Curb Box

TAX ID # 309.15-7-4