

TOWPATH


LN.
~~St.~~
~~Pl.~~
Ave. No. 3

Name of Owner

TAX ID # 309.19-3-4

Labor and Mat'l. Report

19

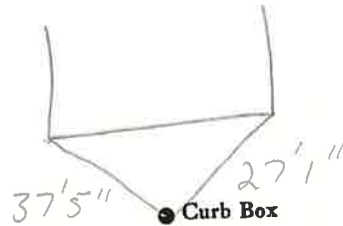

Main

Elev. of Main at tap

Gate at ●

● Gate at

● Curb Box


LSM-5C-6-1-67

Tow Path

St. Pl. Ave. No. 3

Name of Owner

Labor and Mat'l. Report 19

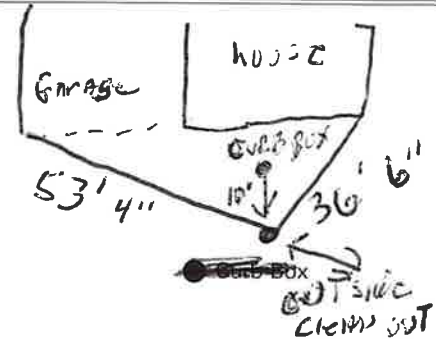

Main

Elev. of Main at tap

Gate at ●

● Gate at

● Curb Box

CLEAN OUT 10' FROM WATER

