

LABOR AND MATERIALS

Copper	}	Connection			\$
Lead					
Curb	}	Cock	} in.		\$
		Valve			
		T.S. & V.			
Service box	}	Short $3\frac{1}{2} \times 4\frac{1}{2}$	} in.		\$
Old returned		Long $4\frac{1}{2} \times 5\frac{1}{2}$			
Ft.	}	Copper	} Pipe at		\$
in.		G. I.			
		C. I.			
Nipples	in.	at			\$
Bushings	to	in.	at		\$
Red'g	}	Coupl'gs	to	in.	at
Inc'g					
Union	in.	at			\$
Meter	in.	at			\$
					\$
Compound Joints	at				\$
Maintenance Foreman					\$
Hrs. Water Maint. Man-1	at				\$
Hrs. Water Maint. Man-2	at				\$
Hrs. Garage Foreman	at				\$
Hrs. Labor	at				\$
Hrs. Compressor	at				\$
					\$
Trucking					\$
Pav't Patch					\$
					\$
					\$
					\$
					\$

LM.
ST.
PT.
Ass. No. 11


TOW PATH

Name of Owner _____

TAX ID # 309.19-4-11

Labor and Mat'l. Report

19

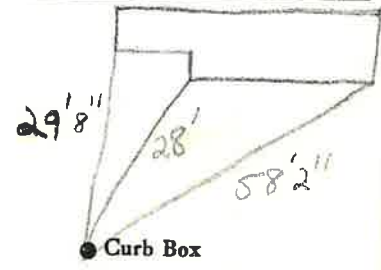

Main	Elev. of Main at tap
Gate at ●	● Gate at

● Curb Box