


LABOR AND MATERIALS

|    |                         |                     |               |    |
|----|-------------------------|---------------------|---------------|----|
| 1  | Copper                  | Connection          | 3/4"          | \$ |
| 1  | Lead                    | Cock                | 3/4" Oriseat. | \$ |
| 1  | Curb                    | Valve               | 3/4" in.      | \$ |
|    |                         | T. S. & V.          |               | \$ |
| 1  | Service box             | Short 3 1/2 x 4 1/2 | 5' x 6'       | \$ |
|    | Old returned            | Long 4 1/2 x 5 1/2  |               |    |
|    |                         | Buff or Rdway       |               |    |
| 12 | Ft. 3/4 in.             | Copper              | Pipe at       | \$ |
|    |                         | G. I.               |               | \$ |
|    |                         | C. I.               |               | \$ |
|    | Nipples                 | in. at              |               | \$ |
|    | Bushings                | to in. at           |               | \$ |
|    | Red'g                   |                     |               | \$ |
|    | Inc'g                   | Coupl'gs. to in. at |               | \$ |
|    | Union                   | in. at              |               | \$ |
|    | Meter                   | in. at              |               | \$ |
|    | Lead Joints             | at                  |               | \$ |
|    | Compound Joints         | at                  |               | \$ |
|    | Maintenance Foreman     |                     |               | \$ |
|    | Hrs. Water Maint. Man-1 | at                  |               | \$ |
|    | Hrs. Water Maint. Man-2 | at                  |               | \$ |
|    | Hrs. Garage Foreman     | at                  |               | \$ |
|    | Hrs. Labor              | at                  |               | \$ |
|    | Hrs. Compressor         | at                  |               | \$ |
|    | Compensation Ins. at \$ | per C               |               | \$ |
|    | Trucking                |                     |               | \$ |
|    | Pav't Patch             |                     |               | \$ |
|    | Tap by Lareau + Co.     |                     |               | \$ |
|    | 6-22-70                 |                     |               | \$ |
|    | O'head                  |                     |               | \$ |

St. \_\_\_\_\_  
 Pl. \_\_\_\_\_  
 Ave. No. 3

Traver  
 Name of Owner  
Arthur Light.

Labor and Mat'l. Report June 22 1970

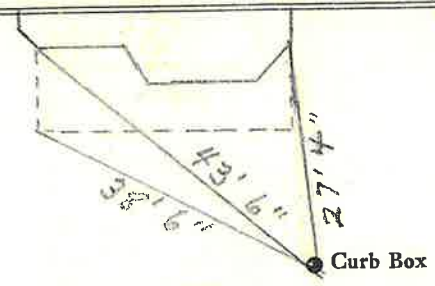

6" Main Elev. of Main at tap 5'

Gate at • Gate at  
3/4" copper 12' to MAIN

• Curb Box  
 TAX ID # 303.17-1-35