


LABOR AND MATERIALS

1	Copper Lead	Connection	3/4"	\$
1	Curb	Cock Valve T. S. & V.	3/4" Oriseal.	\$
1	Service box	Short 3 1/2 x 4 1/2		
	Old returned	Long 4 1/2 x 5 1/2		
		Buff or Rdway		\$
13	Ft.	3/4" in.	Copper G. I. Pipe at	\$
	Nipples	in. at		\$
	Bushings	to in. at		\$
	Red'g			
	Inc'g	Coupl'gs to in. at		\$
	Union	in. at		\$
	Meter	in. at		\$
	Lead Joints at			\$
	Compound Joints at			\$
	Maintenance Foreman			\$
	Hrs. Water Maint. Man-1 at			\$
	Hrs. Water Maint. Man-2 at			\$
	Hrs. Garage Foreman at			\$
	Hrs. Labor at			\$
	Hrs. Compressor at			\$
	Compensation Ins. at \$	per C		\$
	Trucking			\$
	Pav't Patch			\$
	Tap by Gifford & Co.			\$
				\$
		4-14-66.		\$
	O'head			\$
				\$

Traver St. Ave. No. 7

Name of Owner Mrs. Gen. N. Hammond

Labor and Mat'l. Report Apr. 14 1966

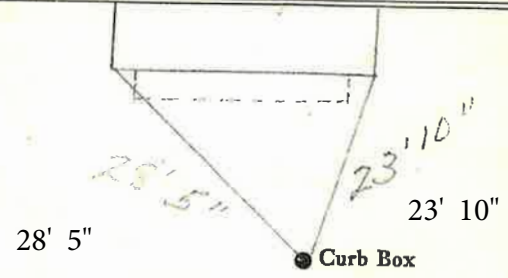

1" Main Elev. of Main at tap 5'

Gate at • Gate at •
3/4" COPPER 13' to MAIN

• Curb Box

TAX ID # 303.17-1-34