

# LABOR AND MATERIALS


_____	Copper } Connection _____	\$ _____
_____	Lead } _____	\$ _____
_____	Curb } Cock } _____ in. _____	\$ _____
	} Valve } _____	
	} T.S. & V. } _____	
_____	Service box { Short 3-1/2 x 4-1/2 } _____	\$ _____
_____	Old returned { Long 4-1/2 x 5-1/2 } _____	\$ _____
_____	Ft. _____ in. { Copper } Pipe at _____	\$ _____
	} G.I. }	
	} C.I. }	
_____	Nipples _____ in. at _____	\$ _____
_____	Bushings _____ to _____ in. at _____	\$ _____
_____	Red'g _____	\$ _____
_____	Inc'g _____	\$ _____
_____	Union _____ in. at _____	\$ _____
_____	Meter _____ in. at _____	\$ _____
_____	_____	\$ _____
_____	Compound Joints at _____	\$ _____
_____	Maintenance Foreman _____	\$ _____
_____	Hrs. Water Maint. Man - 1 at _____	\$ _____
_____	Hrs. Water Maint. Man - 2 at _____	\$ _____
_____	Hrs. Garage Foreman _____ at _____	\$ _____
_____	Hrs. Labor _____ at _____	\$ _____
_____	Hrs. Compressor at _____	\$ _____
_____	_____	\$ _____
_____	Trucking _____	\$ _____
_____	Pav't Patch _____	\$ _____
_____	_____	\$ _____
_____	_____	\$ _____
_____	_____	\$ _____
_____	_____	\$ _____

11 - 11 1/2  
Traver

Pl. Ave. No. \_\_\_\_\_

Name of Owner  
TAX ID # 303.17-1-32

Labor and Mat'l. Report 19

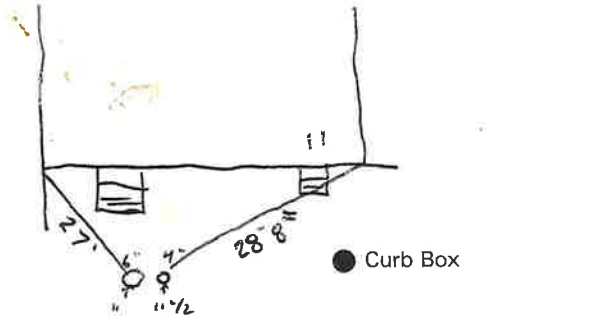

\_\_\_\_\_ Main Elev. of Main at tap \_\_\_\_\_

Gate at ● Gate at ●

\_\_\_\_\_ Curb Box

11 Traver is 6" Cleanout  
11 1/2 out Back is 4" Cleanout.

Labor and Materials

1	Copper	Connection	.....	\$ 1.25
1	Curb	Cock Valve	..... in	\$ 1.70
1	Service Box	Short 3 1/2 x 4 1/2	} .....	\$ 1.37
Old returned	Long 4 1/2 x 5 1/2	Buff. or Rdwy.		
13	Ft. 3/4 in.	Copper Galv. Iron Cast Iron	Pipe at 1 3/4	\$ 1.22
	Nipples	..... in. at	.....	\$ .....
	Bushings	..... to .....	in. at	\$ .....
	Red'g Inc'g	Couplings	..... to .....	in. at \$ .....
	Union	..... in. at	.....	\$ .....
	Meter	..... in. at	.....	\$ .....
	Lbs. Br. Stone	at	.....	\$ .....
	Lbs. Sand	at	.....	\$ .....
	Bags Cement	at	.....	\$ .....
	Paving Brick	Mack Red Asphalt	at	\$ .....
	Lead Joints	at	.....	\$ .....
	Leadite Joints	at	.....	\$ .....
3	Hrs. Foreman	at	6 1/2	\$ 1.88
4	Hrs. Common Labor	at	50	\$ 2.-
8	Hrs. Common Labor	at	45	\$ 3.60
	Hrs. Mason	at	.....	\$ .....
	Hrs. Masons Helper	at	.....	\$ .....
	Hrs. Compressor	at	.....	\$ .....
	Compensation Ins	.....	.....	\$ .28
	Trucking	.....	.....	\$ 1.-
	Builders Use of Water	Patch	.....	\$ 5.-

Total \$19.30

1935-167

Labor and Material Report Nov. 27 1935

Traver St. #11

see below

Void

16'-4"

13'-0"

Curb Box

---

6 C.I. 1965

TAX ID # 303.17-1-32

Main Elev. of Main at tap

---

Gate at

13' to MAIN

---

Curb box for #11 Traver St.

11'-0"

13'-0"

Curb Box

LABOR AND MATERIALS

1	Copper Lead	Connection	$\frac{3}{4}$ "	\$
1	Curb	Cock Valve T.S. & V.	$\frac{3}{4}$ in.	\$
1	Service box	{ Short $3\frac{1}{2}$ x $4\frac{1}{2}$ Long $4\frac{1}{2}$ x $5\frac{1}{2}$ Buff or Rdway }		\$
	Old returned			
14	Ft.	Copper G.I. C.I.	Pipe at	\$
	Nipples	in.	at	\$
	Bushings	to	in. at	\$
	Red'g Inc'g	Coupl'gs.	to in. at	\$
	Union	in.	at	\$
	Meter	in.	at	\$
	Lead Joints	at		\$
	Compound Joints	at		\$
	Maintenance Foreman			\$
	Hrs. Water Maint. Man-1	at		\$
	Hrs. Water Maint. Man-2	at		\$
	Hrs. Garage Foreman	at		\$
	Hrs. Labor	at		\$
	Hrs. Compressor	at		\$
	Compensation Ins.	at \$	per C.	\$
	Trucking			\$
	Pav't Patch			\$
	Tap by Giggard & Co			\$
		6-24-65		\$
	O'head			\$

Stub.


Travel

St. Pl. Ave. No. 11 1/2

Name of Owner

TAX ID # 303.17-1-32

Labor and Mat'l. Report June 24-1965

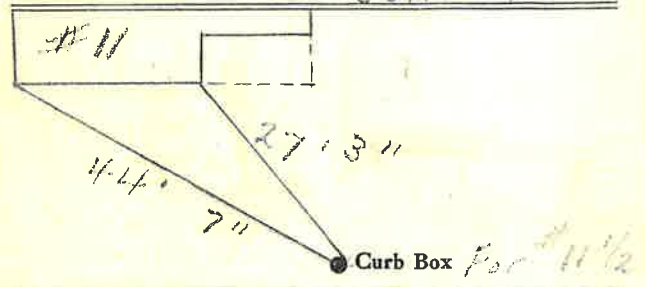

6" Main  
 Curb Box for #11 1/2  
 Rear of #11  
 Elev. of Main at tap 5"

Gate at • Gate at •  
 14" to main

• Curb Box  
 measurements for  
 New 3/4" Tap in rear  
 of #11 Travel St.