

LABOR AND MATERIALS


1	Copper Lead	Connection	$\frac{3}{4}$ "	\$
1	Curb	Cock Valve T.S. & V.	$\frac{3}{4}$ in.	\$
1	Service box	} Short $3\frac{1}{2}$ x $4\frac{1}{2}$ Long $4\frac{1}{2}$ x $5\frac{1}{2}$ Buff or Rdway		\$
2	Old returned			\$
12	Ft. $\frac{3}{4}$ in.	Copper G.I. Pipe at		\$
	Nipples	in. at		\$
	Bushings	to in. at		\$
	Red'g Inc'g	Coupl'gs to in. at		\$
	Union	in. at		\$
	Meter	in. at		\$
	Lead Joints at			\$
	Compound Joints at			\$
	Maintenance Foreman			\$
	Hrs. Water Maint. Man-1 at			\$
	Hrs. Water Maint. Man-2 at			\$
	Hrs. Garage Foreman at			\$
	Hrs. Labor at			\$
	Hrs. Compressor at			\$
	Compensation Ins. at \$	per C		\$
	Trucking			\$
	Pav't Patch			\$
	<i>Found to be Copper</i>			
	<i>Checked by Gifford & Co</i>			
	<i>6-27-28-67</i>			
	O'head			\$

Traver St. Pl. Ave. No. 15

Name of Owner TAX ID # 303.17-1-30

Found to be Copper. Labor and Mat'l. Report June 27-28 1967

TO BE RAZED 1999

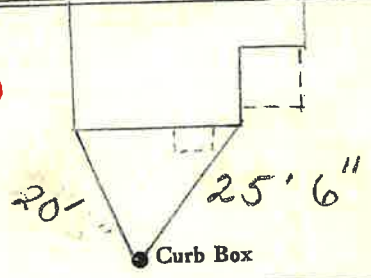

Main Elev. of Main at tap Gate at Gate at 12' to MAIN

Dug up at Curb for Renewal Tap and sound copper June 27+28-1967.