


LABOR AND MATERIALS

1 Copper } Connection $\frac{3}{4}$ " \$ _____
 -Lead }
 1 Curb } Cock } $\frac{3}{4}$ in. \$ _____
 } Valve }
 } T.S. & V. }
 1 Service box } { Short $3\frac{1}{2}$ x $4\frac{1}{2}$ }
 -Old returned } { Long $4\frac{1}{2}$ x $5\frac{1}{2}$ }
 } { Buff or Rdway } \$ _____
 7 Ft. $\frac{3}{4}$ in. } { Copper } Pipe at \$ _____
 } { C.I. }
 } { C.I. }
 _____ Nipples _____ in. at \$ _____
 _____ Bushings _____ to _____ in. at \$ _____
 Red'g }
 Inc'g } Coupl'gs _____ to _____ in. at \$ _____
 _____ Union _____ in. at \$ _____
 _____ Meter _____ in. at \$ _____
 _____ Lead Joints at \$ _____
 _____ Compound Joints at \$ _____
 _____ Maintenance Foreman \$ _____
 _____ Hrs. Water Maint. Man-1 at \$ _____
 _____ Hrs. Water Maint. Man-2 at \$ _____
 _____ Hrs. Garage Foreman _____ at \$ _____
 _____ Hrs. Labor _____ at \$ _____
 _____ Hrs. Compressor at \$ _____
 _____ Compensation Ins. at \$ _____ per C \$ _____
 _____ Trucking \$ _____
 Pav't Patch \$ _____
 Tap by Seymour \$ _____
 11-27-70 \$ _____
 _____ O'head \$ _____
 _____ \$ _____

St. East Tremont
 Ave. No. 17

Name of Owner Rapine

Labor and Mat'l. Report Nov. 27 1970

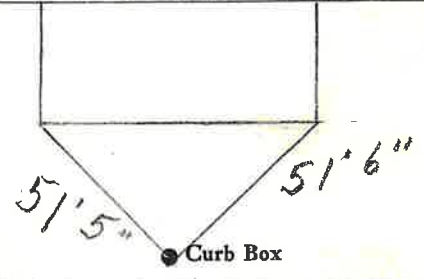

6" Main Elev. of Main at tap 5'
 Gate at • • Gate at

7' to main
 • Curb Box

TAX ID# 309.16-17-7.2