

East  
Tremont St. 18  
Pl. 77  
Ave. No. 77

Name of Owner TAX ID # 309.16-14-20  
A. Williams

Labor and Mat'l. Report Aug 16 19 50

See below 37' Void 45'

Curb Box

6" Main 28' to main Elev. of Main at tap 5'

Gate at • This Tap • Gate at

Changed over from State St. 8-16-50.

Curb Box

56.9" 36.1" 36.1"

Remeasured 10-14-70.

L M-5C-2-1-54

East  
Labor and Material Report October 15 19  
17 Tremont St. 18

Got TY

29.9" 49"

Curb Box

6" Main Elev. of Main at tap 4'

Gate at • Gate at


Curb Box

Tapered State St.


This Tap shut off at Curb box, see state st card for 17 Tremont St. Tap changed 8-16-50



Remeasured  
10-14-70.

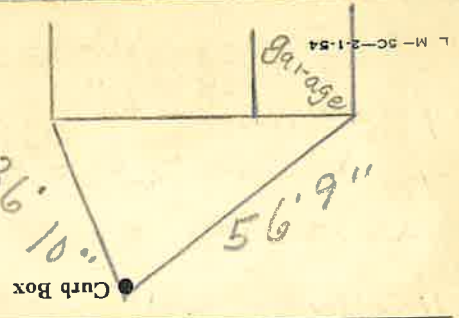

Gate at ● This Tap  
 Changed over from  
 State St. 8-16-50.  
 Main  
 Elev. of  
 Main at tap  
 5'  
 28' to main

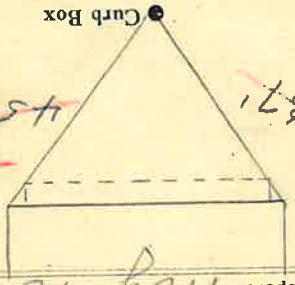

Labor and Mat'l. Report  
Aug 16 1950

Name of Owner  
 THX ID # 309.16-14-20  
 H. Williams  
 Tremont  
 East  
 St.  
 Pl. No. 77  
 18