


LABOR AND MATERIALS

<u>25'</u> Copper	Connection	\$	_____
Lead			
Curb	Cock Valve T.S. & V. } in.	\$	_____
<u>25'</u> Service box	{ Short 3-1/2 x 4-1/2 }	\$	_____
Old returned	{ Long 4-1/2 x 5-1/2 }	\$	_____
<u>22'6"</u> Ft.	<u>3/4</u> in. { Copper G.I. C.I. } Pipe at	\$	_____
<u>KA</u>	Nipples	in. at	\$ _____
	Bushings	to _____ in. at	\$ _____
	Red'g		_____
	Inc'g		_____
	Union	_____ in. at	\$ _____
	Meter	_____ in. at	\$ _____
			\$ _____
	Compound Joints at	\$	_____
	Maintenance Foreman	\$	_____
	Hrs. Water Maint. Man - 1 at	\$	_____
	Hrs. Water Maint. Man - 2 at	\$	_____
	Hrs. Garage Foreman	at _____	\$ _____
	Hrs. Labor	at _____	\$ _____
	Hrs. Compressor at	\$	_____
		\$	_____
	Trucking	\$	_____
	Pav't Patch	\$	_____
		\$	_____
		\$	_____
		\$	_____
		\$	_____

EAST TREMONT ^{St.} _{Pl.} 26
Ave. No.

Name of Owner LARRY CLUTE

Labor and Mat'l. Report ~~49~~ 11/28/2007

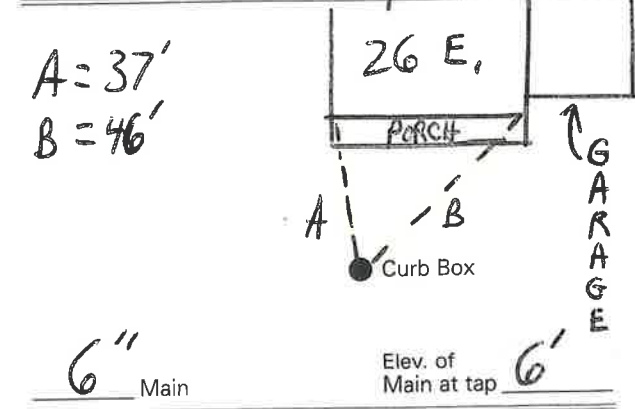

6" Main Elev. of Main at tap 6'
Gate at ● Gate at ●
TAX ID# 309.16-14-23.2

● Curb Box