


LABOR AND MATERIALS

1	Copper Lead	} Connection <u>3/4"</u>	\$
1	Curb		} Cock Valve T.S. & V. <u>3/4" Oriseal</u>
1	Service box	} Short <u>3 1/2 x 4 1/2</u> Long <u>4 1/2 x 5 1/2</u> Buff or Rdway	
30	Ft. <u>3/4</u> in.		} Copper G.I. C.I.
	Nipples	in. at \$	
	Bushings	to in. at \$	
	Red'g } Inc'g }	Coupl'gs to in. at \$	
	Union	in. at \$	
	Meter	in. at \$	
	Lead Joints	at \$	
	Compound Joints	at \$	
	Maintenance Foreman	\$	
	Hrs. Water Maint. Man-1	at \$	
	Hrs. Water Maint. Man-2	at \$	
	Hrs. Garage Foreman	at \$	
	Hrs. Labor	at \$	
	Hrs. Compressor	at \$	
	Compensation Ins. at \$	per C \$	
	Trucking	\$	
	Pav't Patch	\$	
	Tap by Gifford & Co.	\$	
	<u>6-1-67.</u>	\$	
	O'head	\$	
		\$	

St. East Tremont
Pl. 28
Ave. No. 28

Name of Owner Salvatore Leombrano

Labor and Mat'l. Report June 1 1967

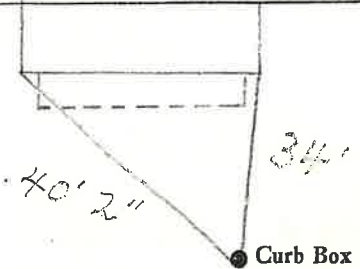

6" Main Elev. of Main at tap 5'

Gate at • Gate at
3/4" Copper 30' to main

• Curb Box

TAX ID # 309.16-14-23.12