


### LABOR AND MATERIALS

364	Copper	Connection	_____	\$	_____
	Lead				
	Curb	Cock Valve } T.S. & V. }	_____ in.	\$	_____
	Service box	{ Short 3-1/2 x 4-1/2 }	_____	\$	_____
	Old returned	{ Long 4-1/2 x 5-1/2 }	_____	\$	_____
14	Ft.	in. { Copper } Pipe at	_____	\$	_____
		{ G.I. }			
		{ C.I. }			
	Nipples	_____ in. at	_____	\$	_____
	Bushings	_____ to _____ in. at	_____	\$	_____
	Red'g				
	Inc'g				
	Union	_____ in. at	_____	\$	_____
	Meter	_____ in. at	_____	\$	_____
				\$	_____
	Compound Joints at	_____		\$	_____
	Maintenance Foreman	_____		\$	_____
	Hrs. Water Maint. Man - 1 at	_____		\$	_____
	Hrs. Water Maint. Man - 2 at	_____		\$	_____
	Hrs. Garage Foreman	_____ at	_____	\$	_____
	Hrs. Labor	_____ at	_____	\$	_____
	Hrs. Compressor at	_____		\$	_____
				\$	_____
	Trucking	_____		\$	_____
	Pav't Patch	_____		\$	_____
				\$	_____
				\$	_____
EAST TREMONT St.  
Pl. Ave. No. 29

Name of Owner  
TAX ID# 309.16-17-4

Labor and Mat'l. Report 5/15/13

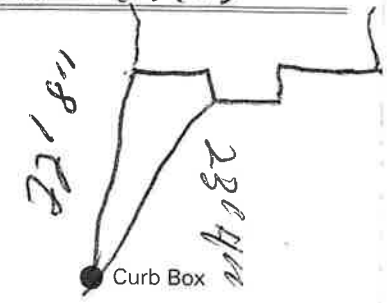

0" Main Elev. of Main at tap 5'  
Gate at ● Gate at ●

● Curb Box

outside clear out  
25 feet to main  
By w/w