

LABOR AND MATERIALS

1	Copper Lead	Connection	$\frac{3}{4}$	\$
1	Curb	Cock Valve T.S. & V.	$\frac{3}{4}$ in.	\$
1	Service box Old returned	Short $3\frac{1}{2} \times 4\frac{1}{2}$ Long $4\frac{1}{2} \times 5\frac{1}{2}$ Buff or Rdway		\$
24	Ft. $\frac{3}{4}$ in.	Copper C.I. C.I.	Pipe at	\$
	Nipples	in. at		\$
	Bushings	to in. at		\$
	Red'g Inc'g	Coupl'gs. to in. at		\$
	Union	in. at		\$
	Meter	in. at		\$
	Lead Joints at			\$
	Compound Joints at			\$
	Maintenance Foreman			\$
	Hrs. Water Maint. Man-1 at			\$
	Hrs. Water Maint. Man-2 at			\$
	Hrs. Garage Foreman at			\$
	Hrs. Labor at			\$
	Hrs. Compressor at			\$
	Compensation Ins. at \$	per C		\$
	Trucking			\$
	Pav't Patch			\$
	Taps			\$
	O'head			\$


Taps Oct 11, 78 by
Herron & Co.

Cast

Tremont St. Pl. Ave. No. 4

Name of Owner
Jerry Coffee

Labor and Mat'l. Report Oct 11, 1978

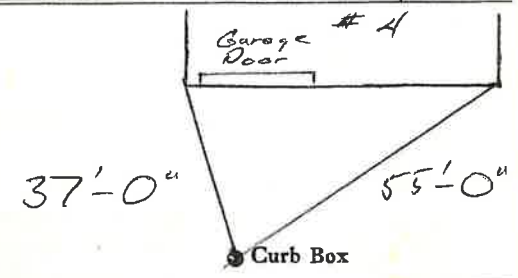

6 Main Elev. of Main at tap 5'

Gate at • Gate at
 $\frac{3}{4}$ " copper 24' to main
• Curb Box

TAX ID # 309.16-14-17