

LABOR AND MATERIALS

1	Copper	} Connection	3/4"	\$ 2.41
	Lead			
1	Curb	} Cock Valve T.S. & V.	} 3/4 in.	\$ 3.41
1	Service box			
	Old returned			
			{ Short 3 1/2 x 4 1/2 Long 4 1/2 x 5 1/2 Buff. or Rdway- }	\$ 4.18
12	Ft. 3/4 in.	} Pipe at	40	\$ 480
	Nipples	in. at		\$
	Bushings	to in. at		\$
	Red'g	} Coupl'gs	to in. at	\$
	Inc'g			
	Union	in. at		\$
	Meter	in. at		\$
	Lead Joints	at		\$
	Compound Joints	at		\$
	Maintenance Foreman			\$
	Hrs. Water Maint. Man	1 at		\$
8	Hrs. Water Maint. Man	2 at	1.74	\$ 9.92
	Hrs. Garage Foreman	at		\$
16	Hrs. Labor	at	1.13	\$ 18.08
	Hrs. Compressor	at		\$
	Compensation Ins.	at \$ 3.861 per C		\$ 1.03
	Trucking			\$ 1.50
	Pay't Patch			\$
	Tap by Gifford	9-10-54		\$
	O'head			\$
				\$ 45.38


4538

64-54

East Tremont St. Pl. Ave. No. 33

Name of Owner La Barge

Labor and Mat'l. Report Sept. 10 19 54

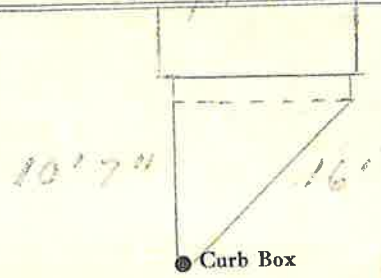

6" Main Elev. of Main at tap 6'

Gate at • Gate at

12' to MAIN

• Curb Box

TAX ID # 309.16-17-2