


LABOR AND MATERIALS

Copper	} Connection	_____	\$ _____			
Lead						
Curb	} Cock	_____ in.	\$ _____			
				} Valve	_____	
						} T. S. & V.
Service box	} Short 3½ x 4½	_____	\$ _____			
Old returned				} Long 4½ x 5½	_____	\$ _____
Ft. 3/4 in.	} Copper	} Pipe at _____	\$ _____			
				} G.I.	_____	\$ _____
Nipples	_____ in. at _____	\$ _____				
Bushings	_____ to _____ in. at _____	\$ _____				
Red'g	} Coupl'gs	_____ to _____ in. at _____	\$ _____			
Inc'g						
Union	_____ in. at _____	\$ _____				
Meter	_____ in. at _____	\$ _____				
		\$ _____				
Compound Joints	at _____	\$ _____				
Maintenance Foreman		\$ _____				
Hrs. Water Maint. Man-1	at _____	\$ _____				
Hrs. Water Maint. Man-2	at _____	\$ _____				
Hrs. Garage Foreman	at _____	\$ _____				
Hrs. Labor	_____ at _____	\$ _____				
Hrs. Compressor	at _____	\$ _____				
		\$ _____				
Trucking		\$ _____				
Pav't Patch		\$ _____				
		\$ _____				
		\$ _____				
		\$ _____				
		\$ _____				

St. PL.
E. TREMONT Ave. No. 41

Name of Owner _____

Labor and Mat'l. Report _____ 1993

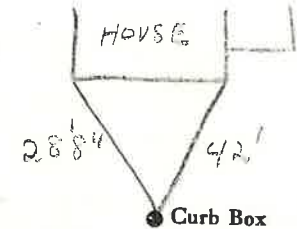

FAYON ST
 Main _____ Elev. of Main at tap _____

Gate at ● _____ Gate at ● _____

● Curb Box

TAP ON FAYON ST.