

56 East

Tremont

St.

Pl.

Ave. No.


75  
36

Name of Owner

Morgan

Labor and Mat'l. Report

June 20 1949

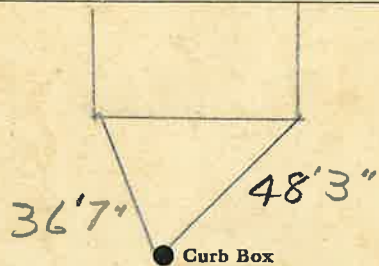

6 Main

Elev. of Main at tap

5'

Gate at ●

● Gate at

● Curb Box

LSM-SC B 15-46

East

Tremont

St.

Pl.

Ave. No.

7

Name of Owner


Harry Morgan

Measured in

Labor and Mat'l. Report

May

1960

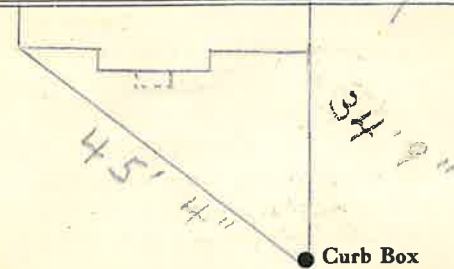

6" Main

Elev. of Main at tap

5'

Gate at ●

● Gate at

8' to main

● Curb Box

TAX ID # 309.16-17-12

LSM-SC-2-5 56

