

St. East Tremont
 Pl. 9
 Ave. No. 9
 Name of Owner Ostrand-Now Bradley
 Labor and Mat'l. Report 19

8-23-97
 Shut off at Bullhead
 leak
 Empty Lot
 48'7"

Gate at ● Gate at ●
 ● Curb Box
 Measured in by Kelly
 Oct. 26. 61

LSM-8C-3-10-61

St. TREMONT
 Ave. No. 9 E.
 Name of Owner TAX ID # 309.16-17-11
 Labor and Mat'l. Report SEPT. 14, 2000

44'10" 54'
 ● Curb Box
 6" Main Elev. of Main at tap _____
 Gate at ● Gate at ●
 3/4" Copper 7' to main
 ● Curb Box

LABOR AND MATERIALS

1	Copper Lead	Connection	3/4	\$	2.80
1	Curb	{ Clock Valve F. S. & V. }	3/4 in.	\$	3.60
1	Service box Old returned	{ Short 3 1/2 X 4 1/2 Long 4 1/2 X 5 1/2 Buff or Rdway }		\$	5.80
8	Ft.	{ Copper Galv. Iron Cast Iron }	35	\$	2.80
	Nipples	in. at		\$	
	Bushings	to in. at		\$	
	Red'g Inc'g	Couplings	to in. at	\$	
	Union	in. at		\$	
	Meter	in. at		\$	
	Lead Joints	at		\$	
	Compound Joints	at		\$	
	Hrs. Foreman	at		\$	
	Hrs. Chauffeur	at		\$	
	Hrs. Tapper	at		\$	
	Hrs. Labor	at		\$	
	Hrs. Labor	at		\$	
	Hrs. Compressor	at		\$	
	Compensation Ins.			\$	
	Trucking			\$	1.50
	Builders Use of Water			\$	
	copy materials			\$	
				\$	
				\$	
				\$	
				\$	

East,

Tramway


St. Pl. 97 Ave. No. 7

Name of Owner

Morgan vs

Labor and Mat'l. Report

Sept 18 1947

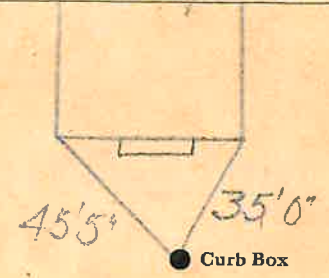

Main

Elev. of Main at tap 5-

Gate at ●

● Gate at

● Curb Box