


LABOR AND MATERIALS

Copper } Connection _____ \$ _____	
Lead } _____ \$ _____	
Curb } Cock Valve } _____ in. _____ \$ _____	
	T. S. & V. }
Service box } Short 3 1/2 x 4 1/2 } _____ \$ _____	
Old returned } Long 4 1/2 x 5 1/2 } _____ \$ _____	
	Buff or Rdway }
6 Ft. 3/4 in. } Copper } Pipe at _____ \$ _____	
	G.I. }
	G.I. }
Nipples _____ in. at _____ \$ _____	
Bushings _____ to _____ in. at _____ \$ _____	
Red'g } Coupl'gs _____ to _____ in. at _____ \$ _____	
Inc'g }	
Union _____ in. at _____ \$ _____	
Meter _____ in. at _____ \$ _____	
Lead Joints at _____ \$ _____	
Compound Joints at _____ \$ _____	
Maintenance Foreman _____ \$ _____	
Hrs. Water Maint. Man-1 at _____ \$ _____	
Hrs. Water Maint. Man-2 at _____ \$ _____	
Hrs. Garage Foreman _____ at _____ \$ _____	
Hrs. Labor _____ at _____ \$ _____	
Hrs. Compressor at _____ \$ _____	
Compensation Ins. at \$ _____ per C _____ \$ _____	
Trucking _____ \$ _____	
Pav't Patch _____ \$ _____	
_____ \$ _____	
_____ \$ _____	
O'head _____ \$ _____	
_____ \$ _____	

E. Tremont St. 13
~~Pl.~~
 Ave. No. 13
 Name of Owner
Falkauski

Labor and Mat'l. Report 19 87

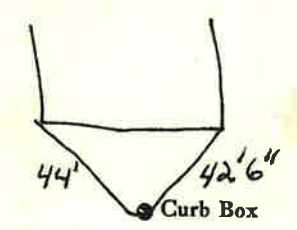

6" Main Elev. of Main at tap _____
 Gate at • Gate at •
3/4" Copper 6' to main
 • Curb Box

TAX ID# 309.16-17-9