

LABOR AND MATERIALS


3/4	Copper } Connection _____	\$ _____
	Lead } _____	\$ _____
	Curb } Cock _____	in. _____ \$ _____
		Valve } _____
		T.S. & V. } _____
	Service box { Short 3-1/2 x 4-1/2 } _____	\$ _____
	Old returned { Long 4-1/2 x 5-1/2 } _____	\$ _____
	Ft. _____ in. { Copper } Pipe at _____	\$ _____
		{ G.I. } _____
		{ C.I. } _____
	Nipples _____ in. at _____	\$ _____
	Bushings _____ to _____ in. at _____	\$ _____
	Red'g _____	\$ _____
	Inc'g _____	\$ _____
	Union _____ in. at _____	\$ _____
	Meter _____ in. at _____	\$ _____
	_____	\$ _____
	Compound Joints at _____	\$ _____
	Maintenance Foreman _____	\$ _____
	Hrs. Water Maint. Man - 1 at _____	\$ _____
	Hrs. Water Maint. Man - 2 at _____	\$ _____
	Hrs. Garage Foreman _____ at _____	\$ _____
	Hrs. Labor _____ at _____	\$ _____
	Hrs. Compressor at _____	\$ _____
	_____	\$ _____
	Trucking _____	\$ _____
	Pav't Patch _____	\$ _____
	_____	\$ _____
	_____	\$ _____
W TREMONT

St. Pl. Ave. No. 14

Name of Owner _____

Labor and Mat'l. Report ~~15~~ 5/15/2005

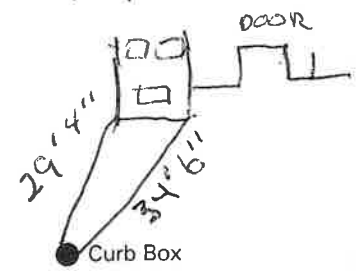

6" Main

Elev. of Main at tap 3'

Gate at ●

● Gate at

TAX ID # 309.16-16-6

● Curb Box