

LABOR AND MATERIALS

Copper	} Connection	_____	\$ _____
Lead			
Curb	} Cock Valve T. S. & V.	_____ in.	\$ _____
Service box Old returned	} Short 3½ x 4½ Long 4½ x 5½	_____	\$ _____
Ft. <u>3/4</u> in.	} Copper G.I. C.I.	Pipe at _____	\$ _____
Nipples _____	in. at _____	\$ _____	
Bushings _____	to _____ in. at _____	\$ _____	
Red'g } Inc'g }	Coupl'gs _____ to _____ in. at _____	\$ _____	
Union _____	in. at _____	\$ _____	
Meter _____	in. at _____	\$ _____	
_____		\$ _____	
Compound Joints at _____		\$ _____	
Maintenance Foreman _____		\$ _____	
Hrs. Water Maint. Man—1 at _____		\$ _____	
Hrs. Water Maint. Man—2 at _____		\$ _____	
Hrs. Garage Foreman _____	at _____	\$ _____	
Hrs. Labor— _____	at _____	\$ _____	
Hrs. Compressor at _____		\$ _____	
_____		\$ _____	
Trucking _____		\$ _____	
Pav't Patch _____		\$ _____	
_____		\$ _____	
_____		\$ _____	
_____		\$ _____	
_____		\$ _____	

W. TREMONT


St. Pl. Ave. No. 29

Name of Owner

TAX ID # 309.15-13-6

Labor and Mat'l. Report

1987

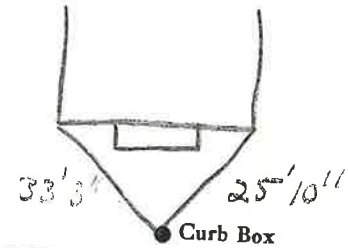

Main

Elev. of Main at tap

Gate at ●

● Gate at

● Curb Box

911 CHANGED ADDRESS TO # 29
FROM # 23, IN SPRING OF 2003,
K4