


LABOR AND MATERIALS

Copper	} Connection		\$	
Lead				
Curb	} Cock Valve T. S. & V. }	in.	\$	
Service box		} Short 3½ x 4½ Long 4½ x 5½ }		
Old returned				\$
22 Ft.	} Copper C.I. C.I. }	3/4 in. Pipe at	\$	
Nipples	in. at		\$	
Bushings	to in. at		\$	
Red'g	} Coupl'gs	to in. at	\$	
Inc'g				
Union	in. at		\$	
Meter	in. at		\$	
			\$	
Compound Joints	at		\$	
Maintenance Foreman			\$	
Hrs. Water Maint. Man	1 at		\$	
Hrs. Water Maint. Man	2 at		\$	
Hrs. Garage Foreman	at		\$	
Hrs. Labor	at		\$	
Hrs. Compressor	at		\$	
			\$	
Trucking			\$	
Pav't Patch			\$	
			\$	
			\$	
			\$	
			\$	

St. W. TREMONT Pt. Ave. No. 31

Name of Owner _____

Labor and Mat'l. Report AUG. 1976

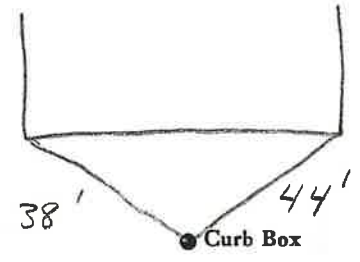

6" Main Elev. of Main at tap 3'

Gate at ● ● Gate at

22 to MAIN

● Curb Box