

LABOR AND MATERIALS


Copper	} Connection	_____	\$	_____	
Lead					
Curb	} Cock Valve } T.S. & V.	_____ in.	\$	_____	
Service box		} Short 3-1/2 x 4-1/2 Long 4-1/2 x 5-1/2	_____	\$	_____
Old returned					
14.1'	} Copper G.I. C.I.	3/4 in.	Pipe at	\$	
Nipples	_____ in.	at	_____	\$	
Bushings	_____ to _____ in.	at	_____	\$	
Red'g					
Inc'g					
Union	_____ in.	at	_____	\$	
Meter	_____ in.	at	_____	\$	
				\$	
Compound Joints	at	_____		\$	
Maintenance Foreman				\$	
Hrs. Water Maint. Man - 1	at	_____		\$	
Hrs. Water Maint. Man - 2	at	_____		\$	
Hrs. Garage Foreman	at	_____		\$	
Hrs. Labor	at	_____		\$	
Hrs. Compressor	at	_____		\$	
				\$	
Trucking				\$	
Pav't Patch				\$	
				\$	
				\$	
				\$	
				\$	

WEST TREMONT

32 LOT 23
St. Pl. Ave. No.

Name of Owner _____
TAX ID # 309.15-16-23

Labor and Mat'l. Report 19 DEC. 30, 2003

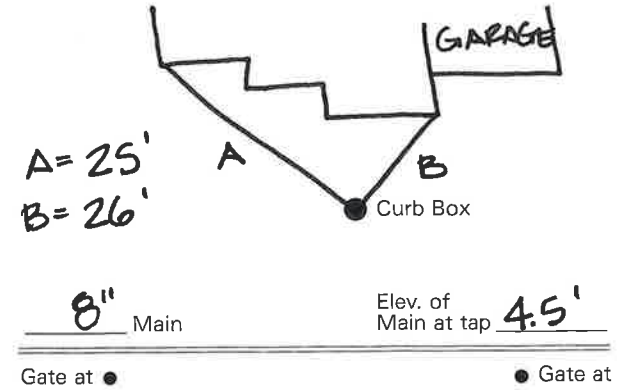

14.1" to main 3/4" Copper

