


LABOR AND MATERIALS

<u>3/4</u>	Copper } Connection _____		\$ _____
	Lead } Cock		
	Curb } Valve _____ in.		\$ _____
		T.S. & V. }	
	Service box { Short 3-1/2 x 4-1/2 }		\$ _____
	Old returned { Long 4-1/2 x 5-1/2 }		\$ _____
	Ft. _____ in. { Copper } Pipe at _____		\$ _____
		G.I. }	
		C.I. }	
	Nipples _____ in. at _____		\$ _____
	Bushings _____ to _____ in. at _____		\$ _____
	Red'g _____		\$ _____
	Inc'g _____		\$ _____
	Union _____ in. at _____		\$ _____
	Meter _____ in. at _____		\$ _____
	_____		\$ _____
	Compound Joints at _____		\$ _____
	Maintenance Foreman _____		\$ _____
	Hrs. Water Maint. Man - 1 at _____		\$ _____
	Hrs. Water Maint. Man - 2 at _____		\$ _____
	Hrs. Garage Foreman _____ at _____		\$ _____
	Hrs. Labor _____ at _____		\$ _____
	Hrs. Compressor at _____		\$ _____
	_____		\$ _____
	Trucking _____		\$ _____
	Pav't Patch _____		\$ _____
	_____		\$ _____
	_____		\$ _____
St. _____
Pl. _____
Ave. No. 15

W TREMONT
Name of Owner _____
TAX ID # 309.16-13-17

Labor and Mat'l. Report 5/15/2005

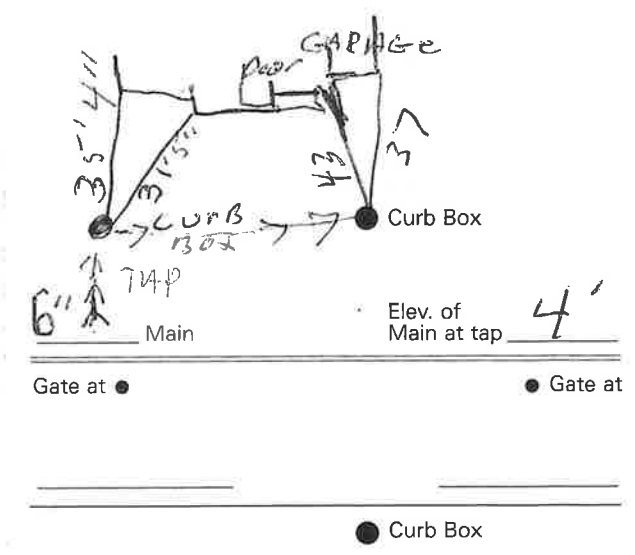

TWO BOXES