


Labor and Materials

1	Copper	Connection	\$1.50
1	Lead				
1	Curb	Cock Valve T.S.&V. }in	\$1.70
1	Service Box	Short 3 1/2 x 4 1/2 } Long 4 1/2 x 5 1/2 } Old returned } Buff. or Rdway }	\$1.44
25	Ft.	Copper } Galv. Iron } Cast Iron }	Pipe at	\$4.75
	Nipplesin. at		\$
	Bushingstoin. at		\$
	Red'g Inc'g	Couplings.....to.....in.at		\$
	Unionin. at		\$
	Meterin. at		\$
	Lbs. Br. Stone	at		\$
	Lbs. Sand	at		\$
	Bags Cement	at		\$
	Paving Brick	Mack } Red } Asphalt }	at	\$
	Lead Joints	at		\$
	Leadite Joints	at		\$
1	Hrs. Foreman	at	62.20	\$	2.63
12	Hrs. Common Labor	at	52	\$	2.25
8	Hrs. Common Labor	at	45	\$	3.60
	Hrs. Mason	at		\$	
	Hrs. Masons Helper	at		\$	
4	Hrs. Compressor	at		\$	6.-
	Compensation Ins			\$	0.16
	Trucking			\$	
	Builders Use of Water			\$	

Total \$20.03.

83 34 Labor and Material Report Aug 21 1934

1755 Tremont St. West

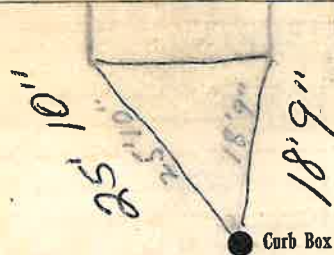

6" Main Elev of Main at tap 4'
Gate at 25' to main Gate at

Curb Box

G. Finch

New House

To be charged.