


LABOR AND MATERIALS

Copper	} Connection _____	\$ _____
Lead		
Curb	} Cock Valve } _____ in. _____ \$ _____ T. S. & V. }	
Service box		} Short 3 1/2 x 4 1/2 } Long 4 1/2 x 5 1/2 }
Old returned		
Ft. 3/4 in.	} Copper C.I. } Pipe at _____ \$ _____ C.I. }	
Nipples _____ in. at _____		
Bushings _____ to _____ in. at _____	\$ _____	
Red'g } Coupl'gs _____ to _____ in. at _____	\$ _____	
Inc'g }		
Union _____ in. at _____	\$ _____	
Meter _____ in. at _____	\$ _____	
Compound Joints at _____	\$ _____	
Maintenance Foreman _____	\$ _____	
Hrs. Water Maint. Man-1 at _____	\$ _____	
Hrs. Water Maint. Man-2 at _____	\$ _____	
Hrs. Garage Foreman _____ at _____	\$ _____	
Hrs. Labor _____ at _____	\$ _____	
Hrs. Compressor at _____	\$ _____	
Trucking _____	\$ _____	
Pav't Patch _____	\$ _____	
_____	\$ _____	
_____	\$ _____	
_____	\$ _____	
_____	\$ _____	

St. W. TREMONT Ave. No. 19

Name of Owner _____
TAX ID # 309.16-13-15

Labor and Mat'l. Report _____ 1991

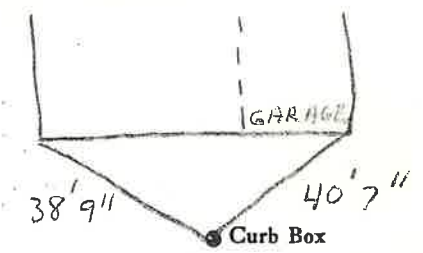

Main _____ Elev. of Main at tap _____
Gate at • _____ Gate at _____

• Curb Box