


LABOR AND MATERIALS

Copper } Connection	_____	\$	_____
Lead } _____		\$	_____
Curb } Cock	} _____ in.	\$	_____
} Valve			
} T. S. & V.			
Service box	{ Short 3 1/2 x 4 1/2 }	\$	_____
Old returned	{ Long 4 1/2 x 5 1/2 }		
22' 2" Ft. 3/4 in. { Copper } Pipe	at _____	\$	_____
26' Nipples	in. at _____	\$	_____
Bushings	to _____ in. at _____	\$	_____
Red'g } Coupl'gs	to _____ in. at _____	\$	_____
Inc'g }			
Union	in. at _____	\$	_____
Meter	in. at _____	\$	_____
Compound Joints	at _____	\$	_____
Maintenance Foreman	_____	\$	_____
Hrs. Water Maint. Man-1	at _____	\$	_____
Hrs. Water Maint. Man-2	at _____	\$	_____
Hrs. Garage Foreman	at _____	\$	_____
Hrs. Labor	at _____	\$	_____
Hrs. Compressor	at _____	\$	_____
Trucking	_____	\$	_____
Pav't Patch	_____	\$	_____
		\$	_____
		\$	_____
W. Tremont St. 23
 Ave. No. 29

Name of Owner _____
 TAX ID # 309.15-13-9

Labor and Mat'l. Report Dec 1989

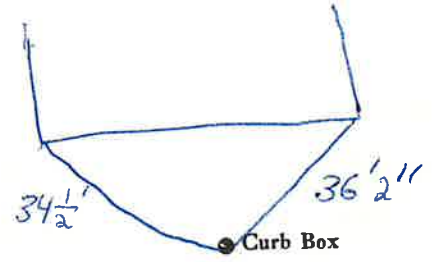

6 Main Elev. of Main at tap _____
 Gate at • Gate at _____
 3/4" copper 26' 27' 2" to main

• Curb Box

911 CHANGED ADDRESS TO #23 IN SPRING OF 2003