


LABOR AND MATERIALS

Copper } Connection		\$
Lead } Cock		
	Valve	
	T.S. & V.	
Curb } } in.		\$
Service box } Short 3½ x 4½		
Old returned } Long 4½ x 5½		\$
27½ Ft. 34 in. } Copper		
	G.I.	
	C.I.	
	Pipe at	\$
Nipples	in. at	\$
Bushings	to in. at	\$
Red'g } Coupl'gs	to in. at	\$
Ine'g }		
Union	in. at	\$
Meter	in. at	\$
		\$
Compound Joints at		\$
Maintenance Foreman		\$
Hrs. Water Maint. Man-1 at		\$
Hrs. Water Maint. Man-2 at		\$
Hrs. Garage Foreman at		\$
Hrs. Labor- at		\$
Hrs. Compressor at		\$
		\$
Trucking		\$
Pav't Patch		\$
		\$
		\$
22 W. Tremont St. 25  
 Ave. No. 27

Name of Owner  
 TAX ID # 309.15-13-8

Labor and Mat'l. Report Dec 1989

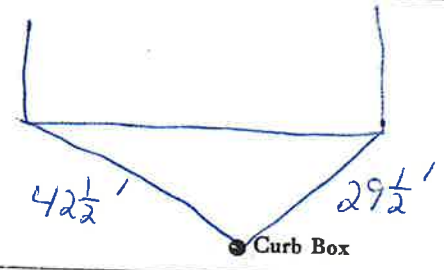

6 Main Elev. of Main at tap  
 Gate at • Gate at

27 1/2' b.m.p.w

• Curb Box

911 CHANGED ADDRESS TO #25  
 FROM #27 IN SPRING OF 2003  
 KH