

LABOR AND MATERIALS

Copper	} Connection	_____	\$		
Lead		_____	\$		
Curb	} Cock	} in.	\$		
				} Valve	} _____
Service box	} Short 3 1/2 x 4 1/2	} _____	\$		
				} Long 4 1/2 x 5 1/2	} _____
Old returned			\$		
Ft. 3/4 in.	} Copper	} Pipe at	\$		
				} G.I.	} _____
} G.I.	} _____		\$		
Nipples	in. at	_____	\$		
Bushings	to in. at	_____	\$		
Red'g	} Coupl'gs	} to in. at	\$		
				} _____	} _____
Union	in. at	_____	\$		
Meter	in. at	_____	\$		
			\$		
Compound Joints	at	_____	\$		
Maintenance Foreman		_____	\$		
Hrs. Water Maint. Man-1	at	_____	\$		
Hrs. Water Maint. Man-2	at	_____	\$		
Hrs. Garage Foreman	at	_____	\$		
Hrs. Labor	at	_____	\$		
Hrs. Compressor	at	_____	\$		
			\$		
Trucking		_____	\$		
Pav't Patch		_____	\$		
			\$		
			\$		
W. TREMONT

St. 27
Pt. 25
Ave. No. 25

Name of Owner _____

TAX ID # 309.15-13-7

Labor and Mat'l. Report 19 87

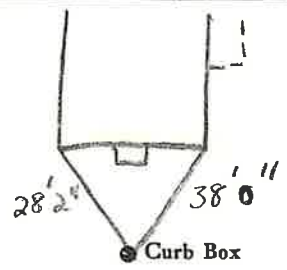

_____ Main	Elev. of Main at top _____
Gate at ●	● Gate at

● Curb Box

911 CHANGED ADDRESS TO #27
FROM #25 IN SPRING OF 2003.
K4