

38--1940

Uncas

St.

Pl.

Ave. No.

5

Name of Owner

Antonsen

Labor and Mat'l. Report

June 21 1940



6 Main

Elev. of Main at tap

9 1/2

Gate at

Gate at

25' to main

3/4" copper

Curb Box

New House

5 Uncas

St.

Pl.


Ave. No.

Name of Owner

MARY WHITE

Labor and Mat'l. Report

2014

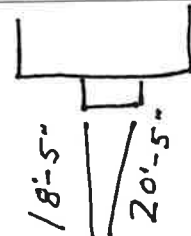

CLEAN OUT

Main

Elev. of Main at tap

Gate at

Gate at

TAX ID# 303.13-15-12

Curb Box

