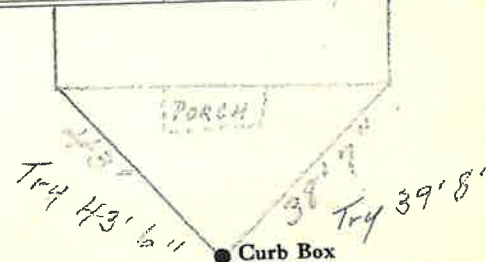


LABOR AND MATERIALS

1 Copper } Connection 3/4" \$
 Lead }
 1 Curb } Cock } 3/4" in. \$
 } Valve }
 } T.S. & V. }
 1 Service box } Short 3 1/2 x 4 1/2 }
 Old returned } Long 4 1/2 x 5 1/2 } \$
 } Buff. or Rdway }
 29 Ft. 3/4" in. } Copper } Pipe at \$
 } G.I. }
 } C.I. }
 Nipples _____ in. at \$
 Bushings _____ to _____ in. at \$
 Red'g }
 Inc'g } Coupl'gs _____ to _____ in. at \$
 Union _____ in. at \$
 Meter _____ in. at \$
 Lead Joints at \$
 Compound Joints at \$
 Maintenance Foreman \$
 Hrs. Water Maint. Man-1 at \$
 Hrs. Water Maint. Man-2 at \$
 Hrs. Garage Foreman _____ at \$
 Hrs. Labor _____ at \$
 Hrs. Compressor at \$
 Compensation Ins. at \$ _____ per C \$
 Trucking \$
 Pav't Patch \$
 TAP BY GIFFORD & CO \$
 3-31-60 \$
 O'head \$
 \$

11000

St. _____
 Pt. _____
 Ave. No. 36
 Name of Owner _____
AUSTIN
 Labor and Mat'l. Report MARCH 31 1960


6" Main Elev. of Main at tap 5'
 Gate at • Gate at
29' to MAIN
3/4" copper • Curb Box
 TAX ID # 303.13-5-2
 LSM-50-2-5 66